


Latitude 38° 25'

Longitude 81° 20'

Topo. Loc.
9665
2.0W

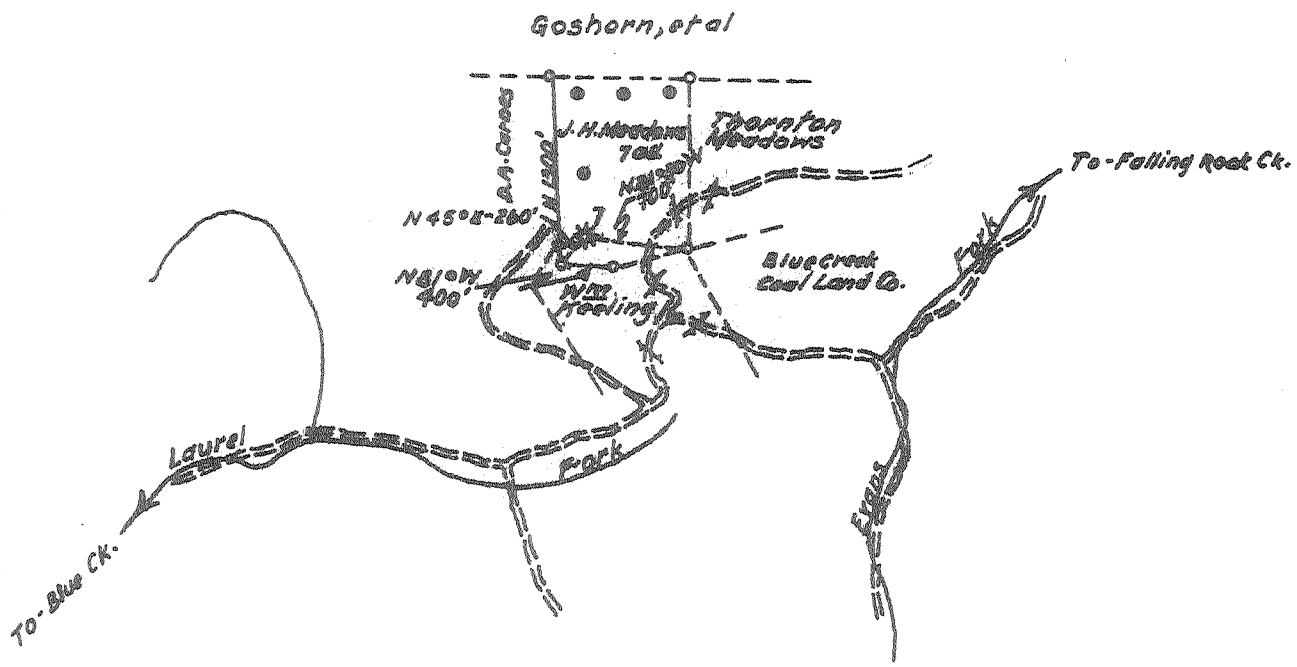

- Fracture Before 6/5/29
- New Location
- Drill Deeper
- Redrill
- Abandonment

I, the undersigned, hereby certify that this map is correct to the best of my knowledge and belief and shows all the information required by Paragraph 5 of the Rules and Regulations of the Oil and Gas Section of the Mining Laws of West Virginia.
The accuracy of this survey is within the limits and as prescribed in Paragraph 5 by the Oil and Gas Division of the Department of Mines Regulations. Source of Elev.: USGS BM - Mouth of Evans Cr. - 704'

Company W.D. & J.W. Frame, dba: Frame Drilling Co.
 Address P.O. Box 404, Elkview, W. Va., 25071
 Farm J.H. Meadows
 Tract _____ Acres 70 Lease No. _____
 Well (Farm) No. L.D. Sample 7 Serial No. _____
 Elevation (Spirit Level) 1345'
 Quadrangle Clendenin C
 County Kanawha District Elk
 Engineer _____
 Engineer's Registration No. _____
 File No. _____ Drawing No. _____
 Date Copied June 9, 1973 Scale 1" = 1320'

STATE OF WEST VIRGINIA
DEPARTMENT OF MINES
OIL AND GAS DIVISION
CHARLESTON

WELL LOCATION MAP
FILE NO. KAN-1428-A

+ Denotes location of well on United States Topographic Maps, scale 1 to 62,500 latitude and longitude lines being represented by border lines as shown.

- Denotes one inch spaces on border line of original tracing.

47-039

FORM OF RECEIVED
AUG 1 1973

STATE OF WEST VIRGINIA
DEPARTMENT OF MINES
OIL AND GAS WELLS DIVISION

OIL & GAS AFFIDAVIT OF PLUGGING AND FILLING WELL

AFFIDAVIT SHOULD BE MADE IN TRIPPLICATE, ONE COPY MAILED TO THE DEPARTMENT, ONE COPY TO BE RETAINED BY THE WELL OPERATOR AND THE THIRD COPY (AND EXTRA COPIES IF REQUIRED) SHOULD BE MAILED TO EACH COAL OPERATOR AT THEIR RESPECTIVE ADDRESSES.

W.D. Frame and J.W. Frame Dbm/ Frame Drilling Co.
 COAL OPERATOR OR OWNER: J.W. Frame
 NAME OF WELL OPERATOR: Frame Drilling Co.
 ADDRESS: Po. Box 404 Elkview W.Va. 25071
 COMPLETE ADDRESS: 7/12/73 19 73
 WELL AND LOCATION: Elk District
 Kanawha County
 LEASE OR PROPERTY OWNER: J.H. Medders Farm
 Well No. 7

STATE INSPECTOR SUPERVISING PLUGGING: Fred Burdette Po Box 1190 Sissonvill 25885
 Ciceron Rt. 984-9263

AFFIDAVIT

STATE OF WEST VIRGINIA, }
 County of _____ } ss:

_____ and _____
 being first duly sworn according to law depose and say that they are experienced in the work of plugging and filling oil and gas wells and were employed by _____, well operator, and participated in the work of plugging and filling the above well, that said work was commenced on the _____ day of _____, 19____, and that the well was plugged and filled in the following manner:

BAND OR ZONE RECORD FORMATION	FILLING MATERIAL	PLUGS USED SIZE & KIND	CASING	
			CSG PULLED	CSG LEFT IN
Plug set 2245 of crushed stone sealing Injun sand.	three bags cement and ten ft.	2" 2286 19"		
set brig at 1777 and 10 ft. crushed stone	bottom of salt sand three bags cement			
7 in. pipe left in hole and all plugs set in pipe				
Bridg set at 650-557 114	three bags of cement and 10 ft. crushed stone			
Plug set at 650 with crushed stone and red mud to 557	557, 550 cement from 540 to 540 crushed stone			
set bridge at 365 at bottom of coal	3 bags cement to 300 ft. red mud to 20 ft.			
20 ft. to 0 Monument set and cemented				
COAL SEAMS	DESCRIPTION OF MONUMENT			
(NAME)	KAN - 1428			
(NAME)				
(NAME)				
(NAME)				

and that the work of plugging and filling said well was completed on the 2 day of July, 1973.

And further deponents saith not.

W.D. Frame
 J.W. Frame
 Fred Burdette
 Notary Public.

Sworn to and subscribed before me this 15th day of August, 1973.

My commission expires: JAN. 12, 1980

Permit No. KAN-1428-1

JUL 17 1973