


Latitude

38° 35'

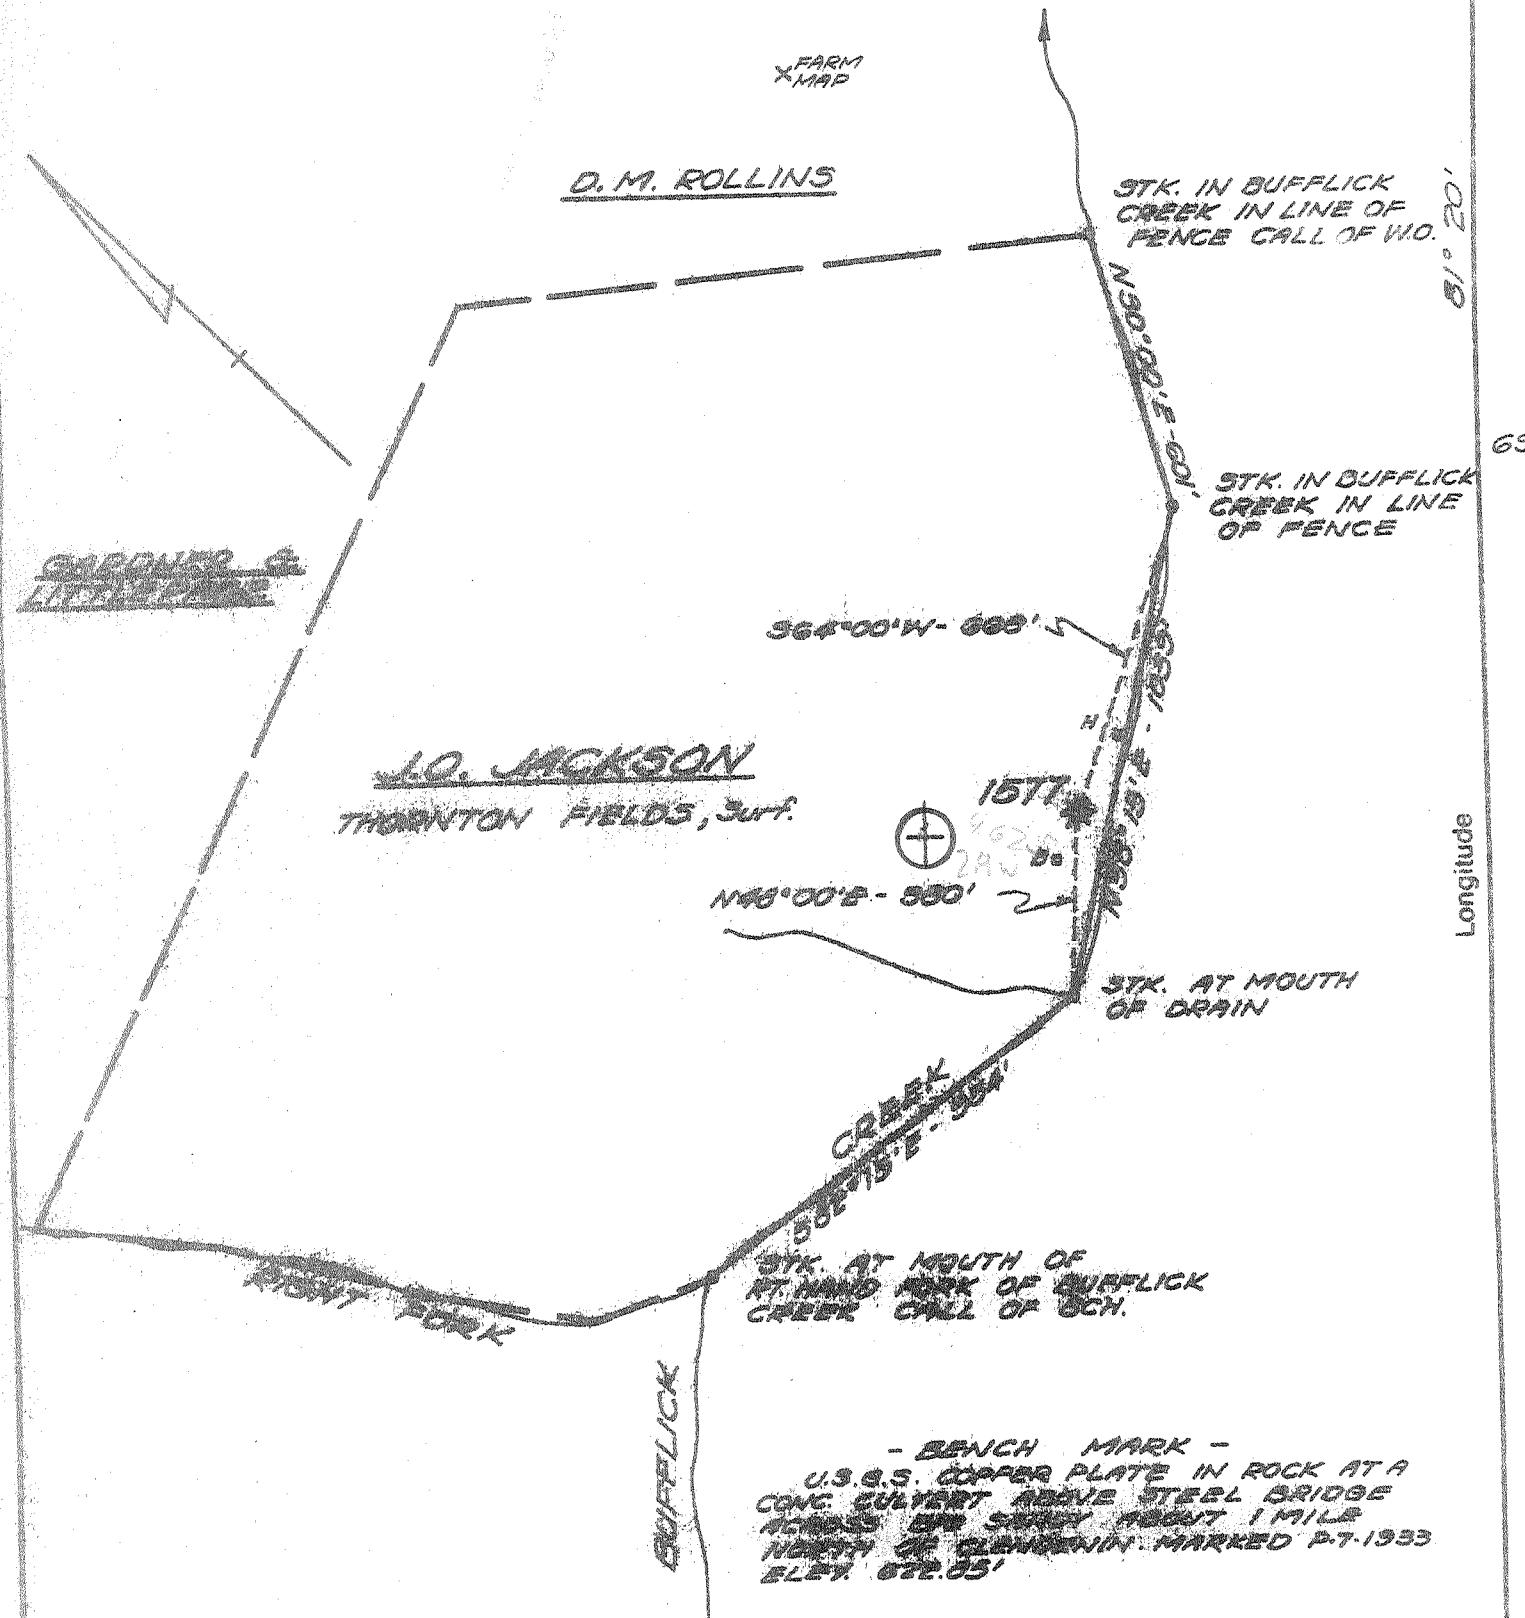

New Location
 Storage
 OH Number
 Abandonment
 Run Down / Fracture

"I, the undersigned, hereby certify that this map is correct to the best of my knowledge and belief and shows all the information required by the rules and regulations of the oil and gas division of the mining laws of W. Va.
 Minimum degree of accuracy is one part in 100

REG. ENGR. # 2330

Signed

Company	<u>GW. GAS TRADING CORP.</u>	
Address	<u>CHARLESTON, W. VA.</u>	
Firm	<u>L.O. JACKSON</u>	
Lease	<u>19708</u>	Acres <u>.03</u>
Well Farm No.	<u>1</u>	Ser. No. <u>1577</u>
Elevation - Spirit Level	<u>798.28</u>	
Quadrangle	<u>THORNTON, W. VA. S.C.</u>	
Township or District	<u>BIG SANDY</u>	
County	<u>MINAWHA</u>	
Sec., Lot, Gr.	<u>T</u>	<u>R</u>
Coordinates		
File No.	<u>74-69</u>	Dwg. No.
Date	<u>12-9-71</u>	Scale <u>1" = 400'</u>

WELL LOCATION MAP WEST VIRGINIA

(+) Denotes Values Of Well On United States Topographic Maps

Scale 15' 7 1/2'

HAN-14-36-A

47 039