


1.595
3.50 W

W. H. Cavender Hrs.

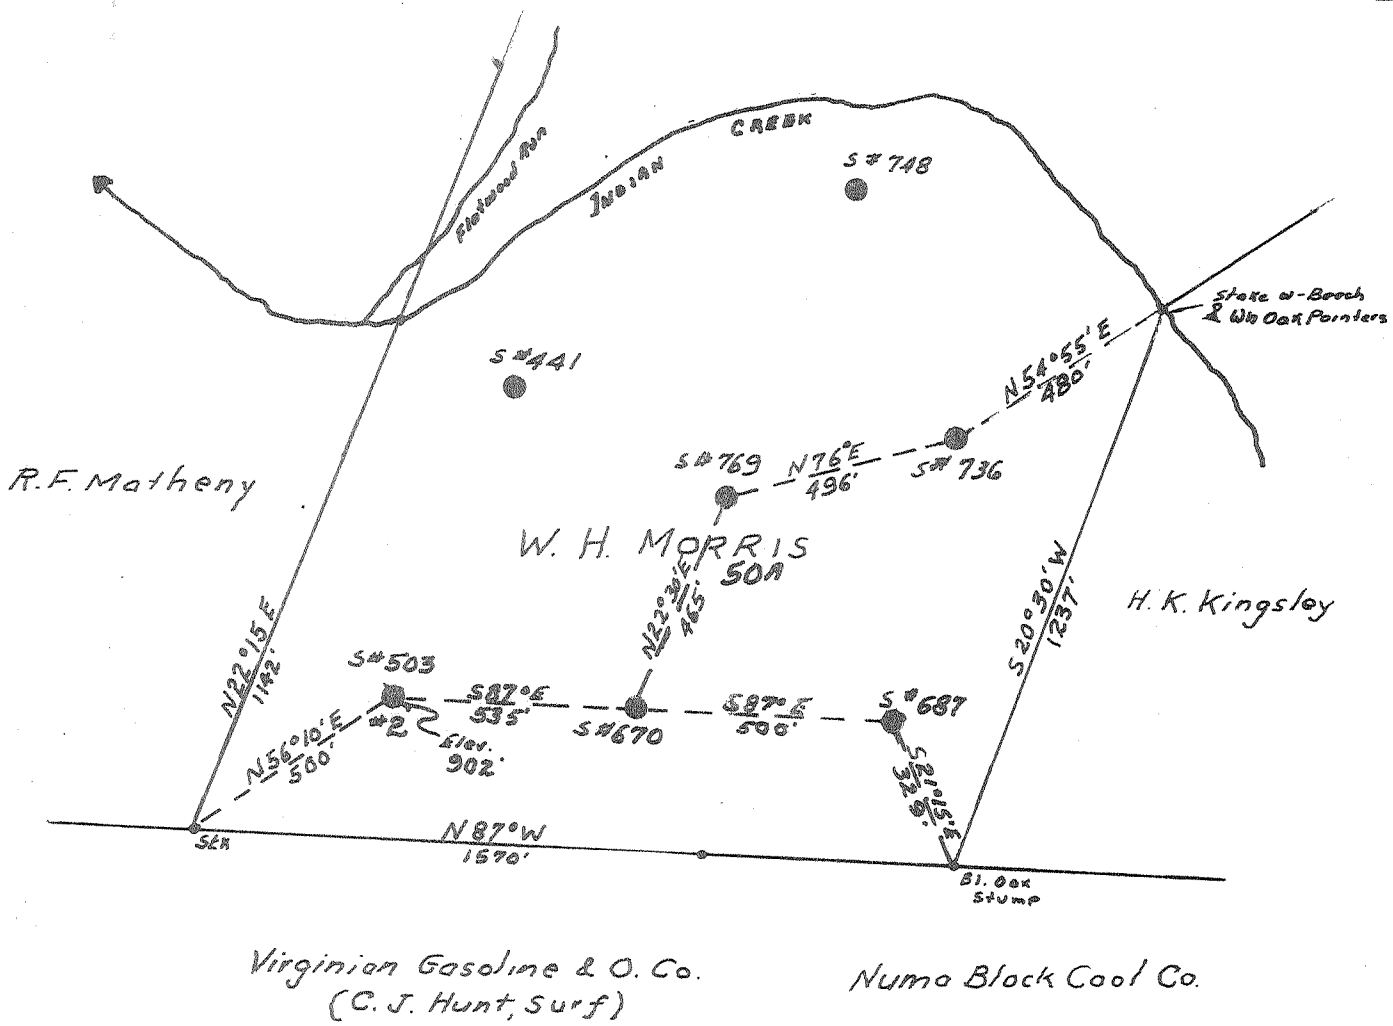

Virginia Gasline & O. Co.
(C. J. Hunt, Surf)

Numa Block Cool Co.

New Location
 Drill Deeper
 Abandonment *issued 8/5/74*

Minimum Error of Closure 1:200'
 Source of Elevation _____

"I, the undersigned, hereby certify that this map is correct to the best of my knowledge and belief and shows all the information required by paragraph 6 of the rules and regulations of the oil and gas section of the mining laws of West Virginia."

Company W.D. FRAME, JR.
 Address Box 263, ELKVIEW, W.VA.
 Farm W. H. MORRIS
 Tract _____ Acres 50 Lease No. _____
 Well (Farm) No. 2 Serial No. 503
 Elevation (Spirit Level) 902
 Quadrangle CLENDENIN WC
 County KANAWHA District ELK
 Engineer G.A. Cunningham
 Engineer's Registration No. 659
 File No. _____ Drawing No. _____
 Date 7-11-74 (copy) Scale 1" = 400'

STATE OF WEST VIRGINIA
 DEPARTMENT OF MINES
 OIL AND GAS DIVISION
 CHARLESTON

WELL LOCATION MAP
 FILE NO. 1927-1440-A

+ Denotes location of well on United States Topographic Maps, scale 1 to 62,500 latitude and longitude lines being represented by border lines as shown.

- Denotes one inch spaces on border line of original tracing.

47-039