


4/1/78

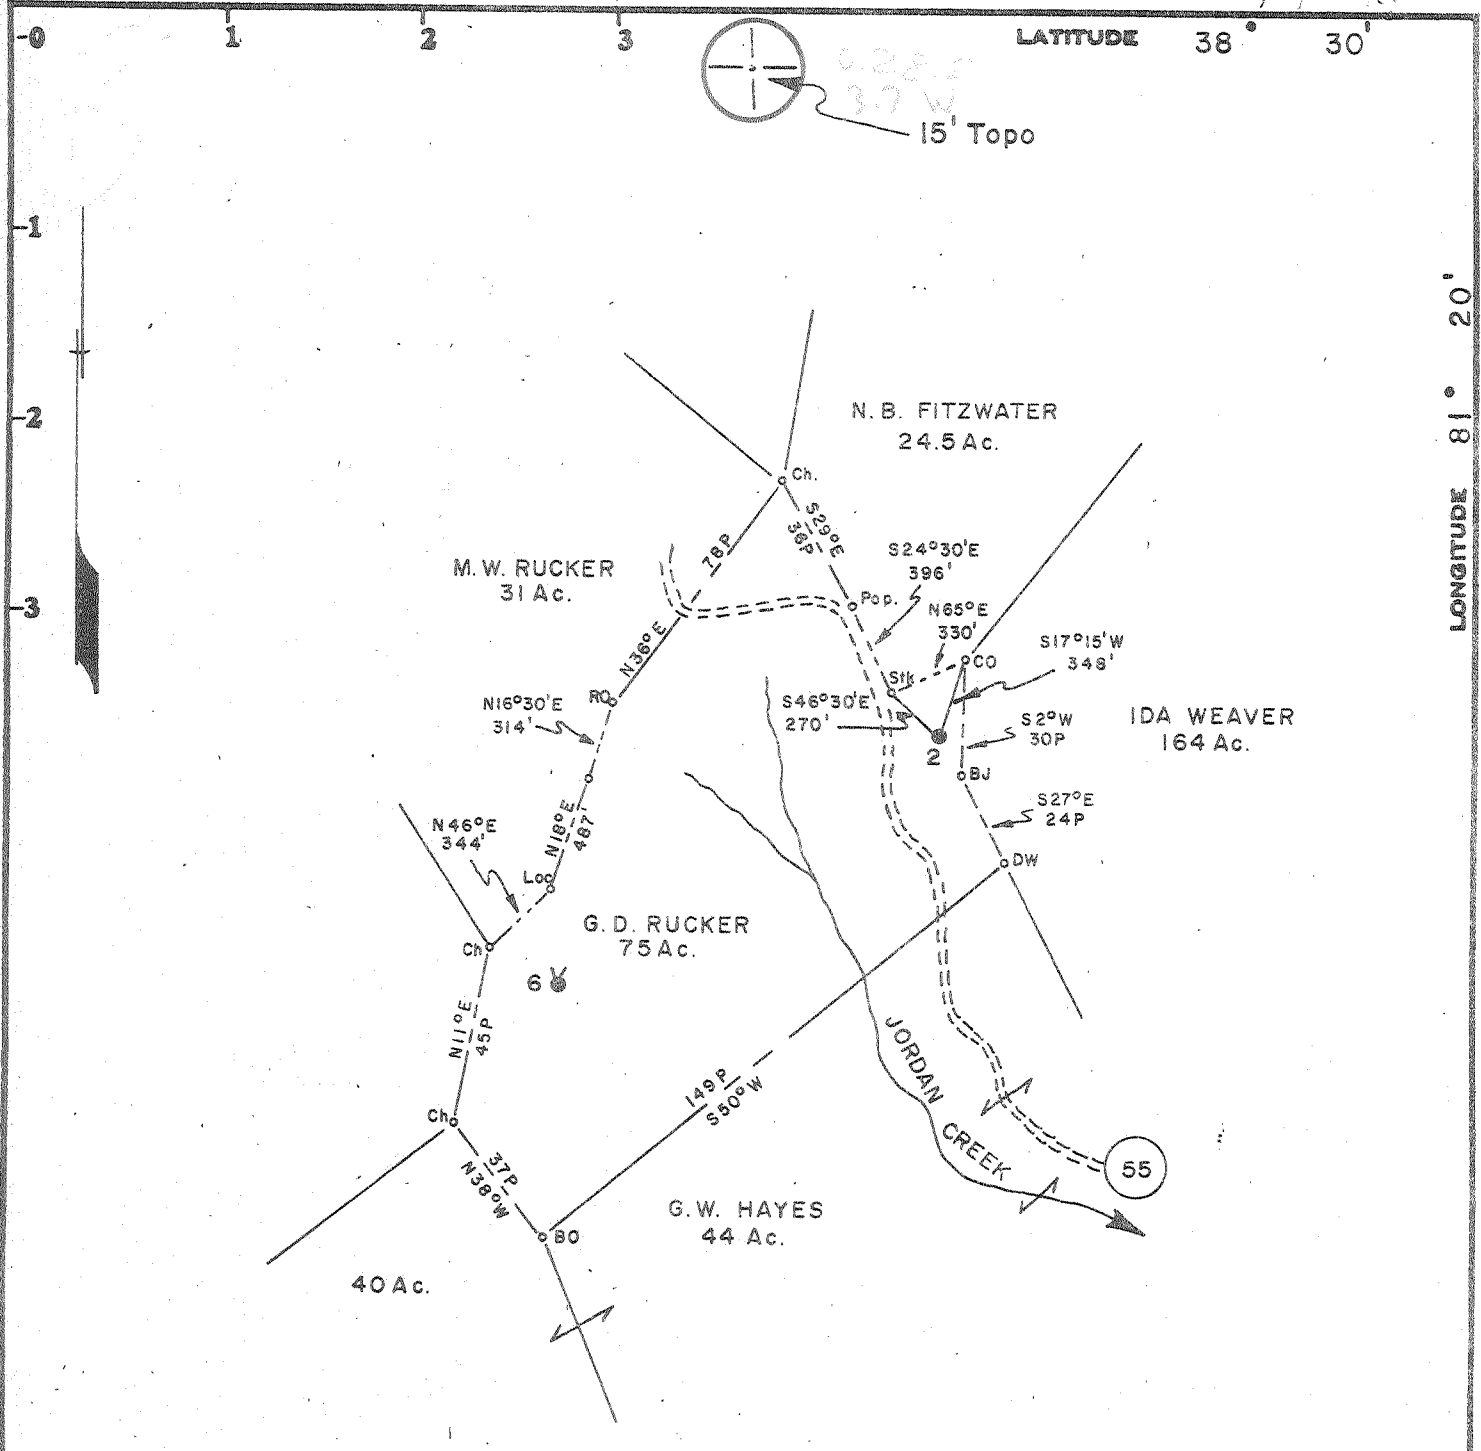

SURFACE-

Romie Wagoner
766 Jordan Ck. Rd.
Elkview WV 25071

Minimum Error of Closure 1 in 200
Source of Elevation USC&G BM "H 96-1956"

- Fracture.....
- New Location.....
- Drill Deeper.....
- Abandonment..... 8/21/78

I, the undersigned, hereby certify that this map is correct to the best of my knowledge and belief and shows all the information required by paragraph 6 of the rules and regulations of the oil and gas section of the mining laws of West Virginia.

Signed: Curtis A. Lucas
Map No. 91 Squares: N 65 E W 45

Company	<u>J&B Contractors</u>		
Address	<u>PO BX 263 ELKIEW WV 25071</u>		
Farm	<u>G.D. RUCKER</u>		
Tract	Acres <u>75</u>	Lease No.	<u>68 21-50</u> <u>68 26-50</u>
Well (Farm) No.	<u>2</u>	Serial No.	
Elevation (Spirit Level)	<u>1022.12 GR.</u>		
Quadrangle	<u>CLENDENIN 15'</u> <u>NC</u>		
County	<u>KANAWHA</u>	District	<u>BIG SANDY</u>
Surveyor	<u>CURTIS A. LUCAS</u>		
Surveyor's Registration No.	<u>275</u>		
File No.	<u>588</u>	Drawing No.	
Date	<u>10-20-76</u>	Scale	<u>1" = 800'</u>

STATE OF WEST VIRGINIA
DEPARTMENT OF MINES
OIL AND GAS DIVISION
CHARLESTON

WELL LOCATION MAP
FILE NO. KAN-1454-A

+ Denotes location of well on United States Topographic Maps, scale 1 to 62,500, latitude and longitude lines being represented by border lines as shown.

— Denotes one inch spaces on border line of original tracing. 47-039 SEP 11 1978