


LATITUDE 38 25

LONGITUDE 81 27 30

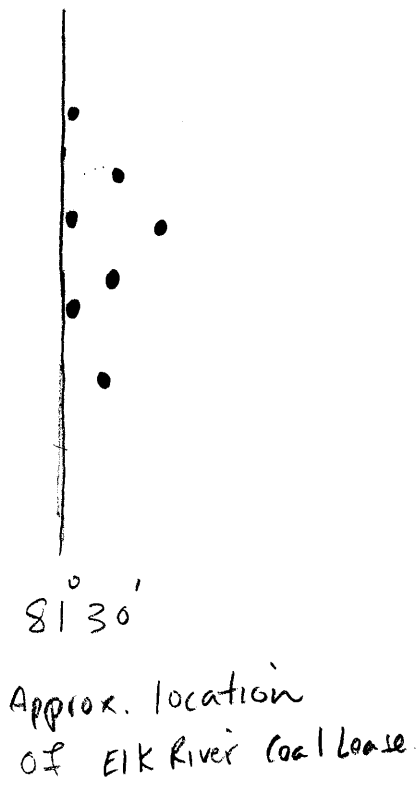

7'5 OGIS topo location

7.5' loc \_\_\_\_\_ 15' loc \_\_\_\_\_  
 \_\_\_\_\_ (calc.) \_\_\_\_\_

Company United Fuel GAS

Farm Elk River Coal Co

Quad Clendenin 15'

County Kanawha

District EIK

WELL LOCATION MAP

File No. 70028

# 382 in Kanawha  
1914 WVGS County RPT.

Elk District, Kanawha County, W. Va.  
 By United Fuel Gas Co.  
 Drilling completed July 23, 1909.  
 Contractors, United Fuel Drilling Co.  
 Drillers, E. B. Sanford and George Davis.  
 F. R. Foraker, foreman.  
 2" tubing; 2 x 6-5/8 x 16 packer.  
 3" tubing (anchor), 170'.  
 Contractors, United Fuel Drilling Co.

?

	Depth.
Salt Sand to	800
Top of Big Lime	1456
Gas in Lime	1580
Bottom of Lime	1605
Red sand, top	1605
Red sand, bottom	1630
White sand, top	1684
Gas in white sand	1694
White sand, bottom	1739
Total depth	1739

Elk District, Kanawha County, W. Va.  
 By United Fuel Gas Co.  
 Drilling completed July 23, 1909.  
 Contractors, United Fuel Drilling Co.  
 Drillers, E. B. Sanford and George Davis.  
 F. R. Feraker, foreman.  
 2" tubing; 2 x 6-5/8 x 16 packer.  
 3" tubing (anchor), 170'.  
 Contractors, United Fuel Drilling Co.

	Depth.
Salt Sand to	800
Top of Big Lime	1456
Gas in Lime	1580
Bottom of Lime	1605
Red sand, top	1605
Red sand, bottom	1630
White sand, top	1684
Gas in white sand	1694
White sand, bottom	1739
Total depth	1739