


LATITUDE 38° 30'

LONGITUDE 81° 25'

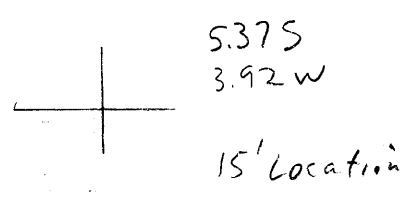

7.5 OGIS topo location

7.5' loc _____ 15' loc _____
 (calc.) _____

Company Ohio Fuel
 Farm J. F. Thumm # 8
 Quad Clendenin
 County Kanawha
 District ELK

WELL LOCATION MAP
 File No. 40045 70101
 # 8 in 1914 WVGES
 Kanawha County Report