


LATITUDE 38° 30'

LONGITUDE 81° 25'

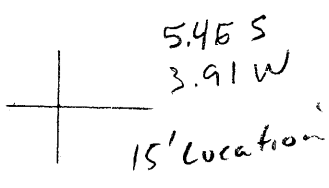

7'5 OGIS topo location

7.5' loc _____ 15' loc _____ ✓
 _____ (calc.) _____

Company Monongahela Oil & Fuel Co

Farm Vernon Jarrett I

Quad Clendenin

County Kanawha

District EIK

WELL LOCATION MAP

File No. 40046 70102

#9 in ¹⁹¹⁴ WVGES
Kanawha County Report