


LATITUDE 38°30'

LONGITUDE 81°25'

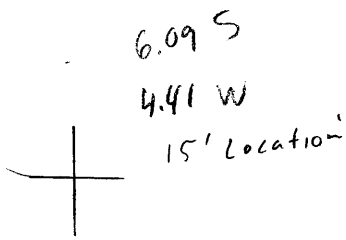

7'5 OGIS topo location

7.5' loc _____ 15' loc _____
 (calc.) _____

Company William S. Edwards Oil Co

Farm Goshorn Heirs #6

Quad Clendenin 15'

County Kanawha

District E1K

WELL LOCATION MAP

File No. 40048 70104

11 in 1914 WGES
Kanawha County Report