


LATITUDE

38° 30'

LONGITUDE 81° 25'

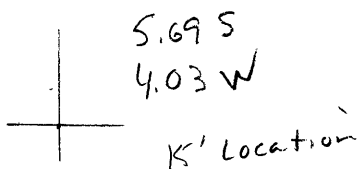

7'5 OGIS topo location

7.5' loc _____ 15' loc _____
 _____ (calc.) _____

Company Grosscup, Rummel & Schwabe Co

Farm D. J. Jarrett 13

Quad Clendenin 15'

County Kanawha

District EIK

WELL LOCATION MAP

File No. 40056 70112

19 12 1914 WVGES

Kanawha County Report