


LATITUDE 38° 30'

LONGITUDE 81° 25'

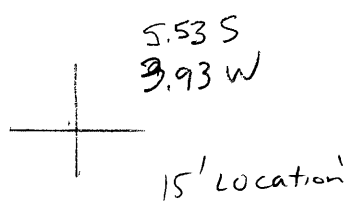

7.5 OGIS topo location

7.5' loc _____ 15' loc _____
 _____ (calc.) _____

Company Monongahela Oil & Fuel Co
 Farm Vernon Jarrett #2
 Quad Clendenin 15'
 County Kanawha
 District E1K

WELL LOCATION MAP
 File No. 40061 70117
 # 27 in 1914 WVGES
 Kanawha County Report