


LATITUDE

38° 30'

LONGITUDE 81° 25'

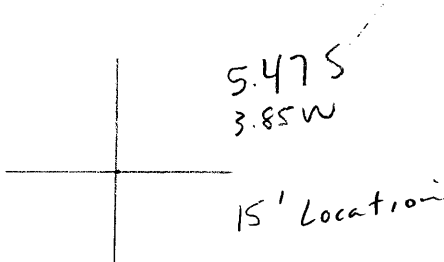

7.5 OGIS topo location

7.5' loc _____ 15' loc _____
 (calc.) _____

Company Grosscup, Rummel & Schwabe Co

Farm D. J. Jarrett #11

Quad Clendenin 15'

County Kanawha

District E1K

WELL LOCATION MAP

File No. 40063 70119

#26 in 1914 WVGES
Kanawha County Report