


LATITUDE 38°30'

LONGITUDE 81°25'

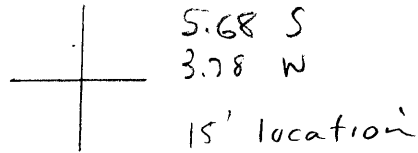

7'5 OGIS topo location

7.5' loc _____ 15' loc _____
 _____ (calc.) _____

Company Grosscup Rummel & Schwabe Co

Farm D. J. Jarrett 12

Quad Cleudenin 15'

County Kanawha

District ER

WELL LOCATION MAP

File No. 40101 70157

#68 in 1914 WVGES
Kanawha County Report