


LATITUDE 38° 30'

LONGITUDE 81° 25'

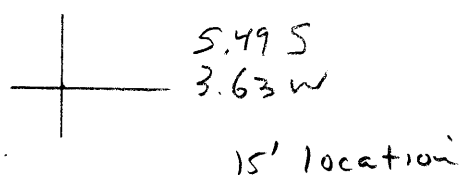

7'5 OGIS topo location

7.5' loc _____ 15' loc _____
 _____ (calc.) _____

Company South Penn

Farm Henry Cline 1

Quad clendenin 15'

County Kanawha

District E/K

WELL LOCATION MAP
 File No. 40126 70182
 93 in 1914 WUGES
 Kanawha County Report