


LATITUDE

38° 30'

LONGITUDE 91° 25'

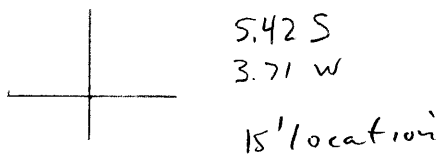

7'5 OGIS topo location

7.5' loc _____ 15' loc _____
 _____ (calc.) _____

Company United Fuel

Farm George Myers 1

Quad Clendenin 15'

County Kanawha

District EIK

WELL LOCATION MAP

File No. 40131 70187

98 in 1914 WVGES

Kanawha County Report