


LATITUDE 38° 30'

LONGITUDE 81° 25'

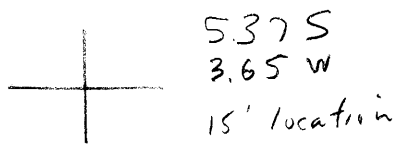

7.5 OGIS topo location

7.5' loc _____ 15' loc _____
 _____ (calc.) _____

Company Ohio Fuel

Farm EC Myers I

Quad Clendenin 15'

County Kanawha

District E1K

WELL LOCATION MAP

File No. 40133 70189

100 in 1914 WVGES

Kanawha County Report