


LATITUDE 38° 30'

LONGITUDE 81° 25'

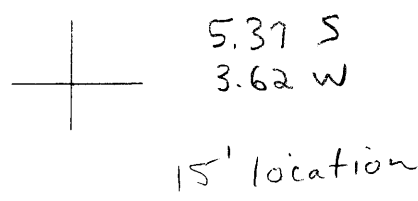

7'5 OGIS topo location

7.5' loc _____ 15' loc _____
 (calc.) _____

Company United Fuel

Farm Green Smith 2

Quad Clendenin 15'

County Canawha

District E1K

WELL LOCATION MAP
 File No. 40134 70190
 101 in 1914 WGES
 Kanawha County Report