


LATITUDE 38°30'

LONGITUDE 81°25'

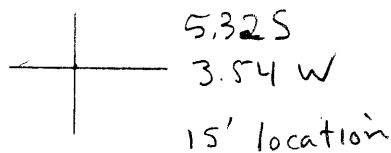

7.5 OGIS topo location

7.5' loc \_\_\_\_\_ 15' loc \_\_\_\_\_  
 \_\_\_\_\_ (calc.) \_\_\_\_\_

Company United Fuel

Farm Green Smith 1

Quad Clendenin 15'

County Kanawha

District E1K

WELL LOCATION MAP

File No. 40137 70193

#105 in 1914 WGES  
Kanawha County Report