


LATITUDE 38°30'

LONGITUDE 81°25'

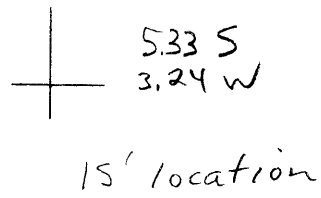

7'5 OGIS topo location

7.5' loc _____ 15' loc _____
 _____ (calc.) _____

Company South Penn
 Farm Om Jarrett 4
 Quad Clendenin 15'
 County Kanawha
 District E1K

WELL LOCATION MAP
 File No. 40143 70199
 #112 in 1914 WUGES
 Kanawha County Report