


LATITUDE

38° 30'

LONGITUDE 81° 25'

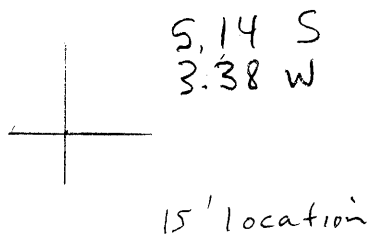

7.5 OGIS topo location

7.5' loc _____ 15' loc _____
 (calc.) _____

Company Ohio Fuel

Farm J F Thumm I

Quad Clendenin 15'

County Kanawha

District E1K

WELL LOCATION MAP

File No. 40145 70201

115 m 1914 WVGES
Kanawha County Report