


LATITUDE 38° 30'

LONGITUDE 81° 25'

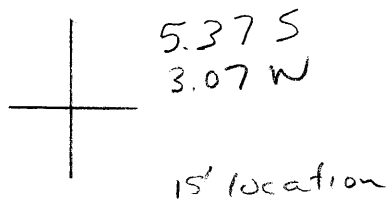

7'5 OGIS topo location

7.5' loc \_\_\_\_\_ 15' loc \_\_\_\_\_  
 \_\_\_\_\_ (calc.) \_\_\_\_\_

Company South Penn

Farm V. C. Myers 5

Quad Clendenin 15'

County Kanawha

District E/A

WELL LOCATION MAP

File No. 40157 70213

**30** in 1914 WVGES

Kanawha County Report