


LATITUDE 38° 30'

LONGITUDE 81° 25'

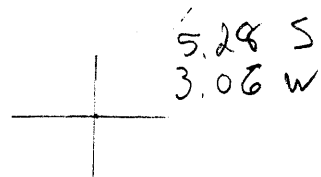

7'5 OGIS topo location

7.5' loc _____ 15' loc _____
 _____ (calc.) _____

Company Ohio Fuel

Farm W L Booker 2

Quad Clendenin 15'

County Kanawha

District E1K

WELL LOCATION MAP

File No. 40159 70215

132 in 1914 WVGES

Kanawha County Report