


LATITUDE 38° 30'

LONGITUDE 81° 25'

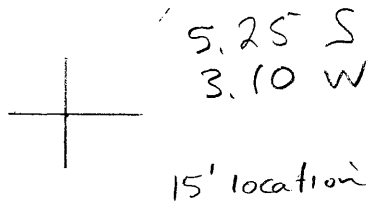

7.5 OGIS topo location

7.5' loc \_\_\_\_\_ 15' loc \_\_\_\_\_  
 \_\_\_\_\_ (calc.) \_\_\_\_\_

Company South Penn

Farm V.C. Meyers 6

Quad Clendenin 15'

County Kanawha

District E1K

WELL LOCATION MAP

File No. 40160 70216

133 in 1914 WVGES

Kanawha County  
Report