


LATITUDE

38° 30'

LONGITUDE 81° 25'

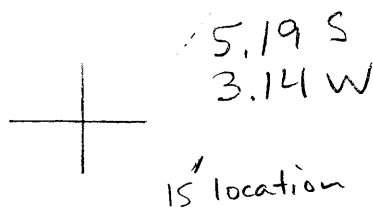

7.5 OGIS topo location

7.5' loc _____ 15' loc _____
 _____ (calc.) _____

Company South Penn

Farm V. C. Myers 4

Quad Clendenin 15'

County Kanawha

District E1K

WELL LOCATION MAP

File No. 40161 70217

134 in 1914 WGES

Kanawha County Report