


LATITUDE

38° 30'

LONGITUDE 81° 25'

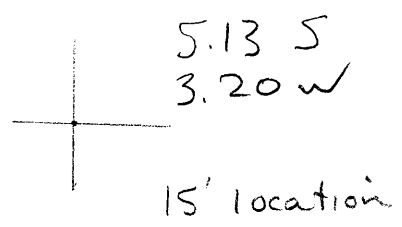

7'5 OGIS topo location

7.5' loc _____ 15' loc _____
 _____ (calc.) _____

Company South Penn

Farm V.C. Myers 2

Quad Clendenin 15'

County Kanawha

District EIK

WELL LOCATION MAP

File No. 40162 70218

135 in 1914 WGES
Kanawha County Report