


LATITUDE 38°30'

LONGITUDE 81°25'

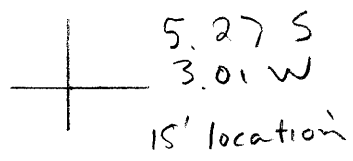

7'5 OGIS topo location

7.5' loc \_\_\_\_\_ 15' loc \_\_\_\_\_  
 \_\_\_\_\_ (calc.) \_\_\_\_\_

Company Ohio Fuel  
 Farm W.L. Booker #3  
 Quad Cleburn 15'  
 County Kanawha  
 District EIK

WELL LOCATION MAP  
 File No. 40166 70222  
 # 139 in Kanawha  
 CO RPT