


LATITUDE 38° 30'

LONGITUDE 81° 25'

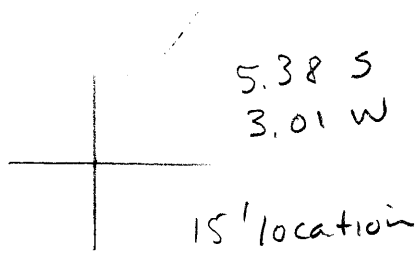

7'5 OGIS topo location

7.5' loc _____ 15' loc _____
 _____ (calc.) _____

Company Ohio Fuel

Farm W. L. Booker 4

Quad Clendenin 15'

County Kanawha

District E1K

WELL LOCATION MAP

File No. 40167 70223

140 in Kanawha
1914 WVS
CO RPT