


LATITUDE 38°30'

LONGITUDE 81°25'

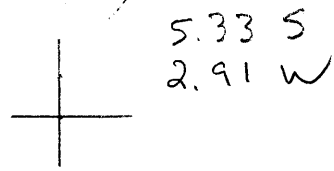

7'5 OGIS topo location

7.5' loc _____ 15' loc _____
 _____ (calc.) _____

Company Ohio Fvel
 Farm W. L. Booker 5
 Quad Clendenin 15'
 County Kanawha
 District E 1K

WELL LOCATION MAP
 File No. 40168 70224
 # 141 in Kanawha
CO RPT
1914 WUGES