


LATITUDE 38°30'

LONGITUDE

81°25'

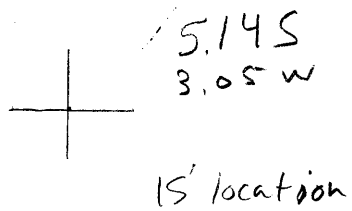

7.5 OGIS topo location

7.5' loc _____ 15' loc _____
 _____ (calc.) _____

Company South Penn

Farm Albert Myers 8

Quad Clendenin 15'

County Kanawha

District EIK

WELL LOCATION MAP

File No. 40169 70225

#142 in 1914

WVGES Kanawha
County Report