


LATITUDE

38° 30'

LONGITUDE 81° 25'

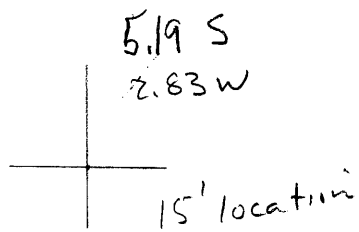

7'5 OGIS topo location

7.5' loc \_\_\_\_\_ 15' loc \_\_\_\_\_  
 \_\_\_\_\_ (calc.) \_\_\_\_\_

Company South Penn

Farm Albert Myers S

Quad Clendenin 15'

County Kanawha

District ELK

WELL LOCATION MAP

File No. 40172 70228

# 145 in 1914 WUGES

Kanawha County RPT.