


LATITUDE 38° 30'

LONGITUDE 81° 25'

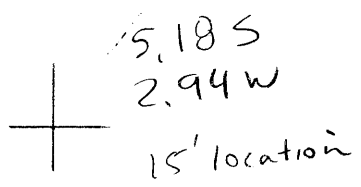

7.5 OGIS topo location

7.5' loc \_\_\_\_\_ 15' loc \_\_\_\_\_  
 \_\_\_\_\_ (calc.) \_\_\_\_\_

Company United Fuel  
 Farm BA Wise 4  
 Quad Clendenin 15'  
 County Kanawha  
 District E1K

WELL LOCATION MAP  
 File No. 40173 70729  
 # 146 in 1914 WVGES  
 Kanawha County Report