


LATITUDE 38° 30'

LONGITUDE

81° 25'

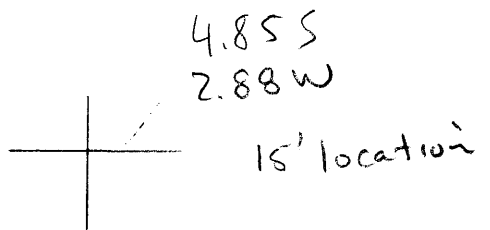

7.5 OGIS topo location

7.5' loc _____ 15' loc _____
 _____ (calc.) _____

Company South Penn

Farm Albert Myers 6

Quad Clendenin 15'

County Kanawha

District EIK

WELL LOCATION MAP

File No. 40176 70232

149 in ^{1914 WGES} Kanawha

County Report