


LATITUDE 38°30'

LONGITUDE 81°25'

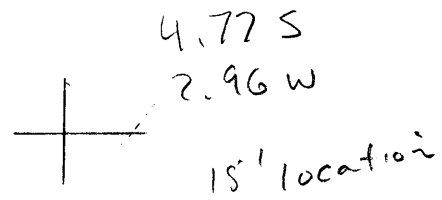

7.5 OGIS topo location

7.5' loc \_\_\_\_\_ 15' loc \_\_\_\_\_  
 \_\_\_\_\_ (calc.) \_\_\_\_\_

Company South Penn

Farm Albert Myers 2

Quad Clendenia 15'

County Kanawha

District ELK

WELL LOCATION MAP

File No. 40178 70233

#156 in 1914 WUGES

Kanawha County Report