


LATITUDE 38° 30'

LONGITUDE 81° 25'

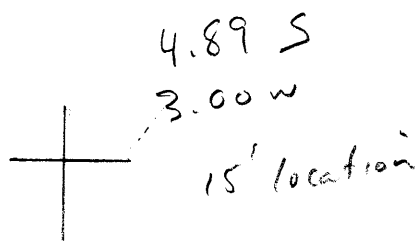

7.5 OGIS topo location

7.5' loc _____ 15' loc _____
 _____ (calc.) _____

Company South Penn

Farm Albert Myers 7

Quad Clendenin 15'

County Kanawha

District E1K

WELL LOCATION MAP

File No. 40179 70234

157 in Kanawha

1914 ~~WV~~ ^{WV} county Report