


LATITUDE

38° 30'

LONGITUDE 81° 25'

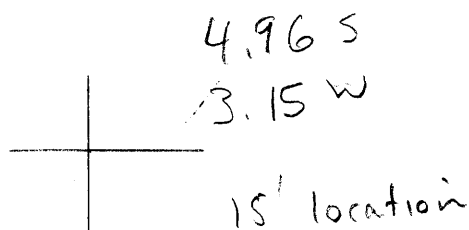

7.5 OGIS topo location

7.5' loc _____ 15' loc _____
 _____ (calc.) _____

Company South Penn

Farm U.C. Myers 1

Quad Clendenin 15'

County Kanawha

District ELK

WELL LOCATION MAP

File No. 40181 70236

159 in Kanawha
1914 WVGES Co RPT