


LATITUDE 38°30'

LONGITUDE 81°25'

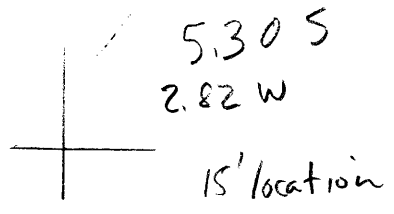

7.5 OGIS topo location

7.5' loc _____ 15' loc _____
 _____ (calc.) _____

Company Ohio Fuel

Farm W.L. Booker 6

Quad Clendenin 15'

County Kanawha

District E1K

WELL LOCATION MAP

File No. 40183 70238

162 in 1914 WUGES
Kanawha County Report