


LATITUDE 38° 30'

LONGITUDE 81° 25'

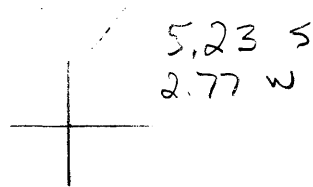

7.5 OGIS topo location

7.5' loc \_\_\_\_\_ 15' loc \_\_\_\_\_  
 \_\_\_\_\_ (calc.) \_\_\_\_\_

Company Ohio Fuel  
 Farm J. H. Boggs 2  
 Quad Clendenin 15'  
 County Kanawha  
 District E1K

WELL LOCATION MAP  
 File No. 40185 70240  
 #164 in Kanawha  
 1914 WVGES County Report