


LATITUDE 38° 30'

LONGITUDE 81° 25'

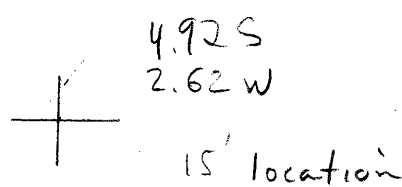

7'5 OGIS topo location

7.5' loc _____ 15' loc _____
 _____ (calc.) _____

Company Ohio Fuel

Farm G. A. White 1

Quad Clendenin 15'

County Kanawha

District Elk

WELL LOCATION MAP

File No. 40190 70245

#169 in Kanawha

1914 WVGES County Report