


LATITUDE 38° 30'

LONGITUDE 81° 25'

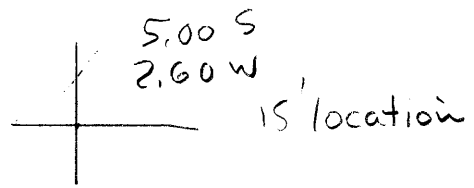

7.5 OGIS topo location

7.5' loc _____ 15' loc _____
 _____ (calc.) _____

Company United Fuel

Farm B. A. Wise I

Quad Clendenin 15'

County Kanawha

District EIK

WELL LOCATION MAP

File No. 40191 70246

171 in Kanawha

1914 WUGES County Report