


LATITUDE 38°30'

LONGITUDE 81°25'

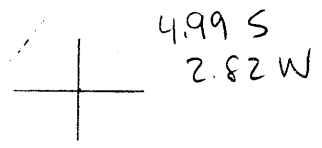

7'5 OGIS topo location

7.5' loc \_\_\_\_\_ 15' loc \_\_\_\_\_  
 \_\_\_\_\_ (calc.) \_\_\_\_\_

Company Ohio Fuel

Farm M. E. Morris 2

Quad Clendenin 15'

County Kanawha

District E1K

WELL LOCATION MAP

File No. 40193 70248

# 173 in Kanawha

1914 W.V. COES  
County Report