


LATITUDE 38° 30'

LONGITUDE 81° 25'

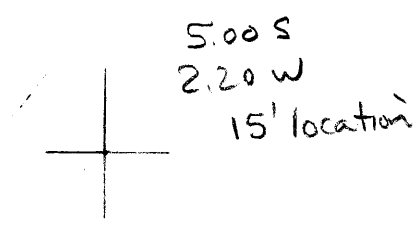

7'5 OGIS topo location

7.5' loc _____ 15' loc _____
 _____ (calc.) _____

Company United Fuel

Farm R. E. McCabe 2

Quad Clendenin 15'

County Kanawha

District EIK

WELL LOCATION MAP
 File No. 40194 70249
 #174 in Kanawha
 County Report

1914 W 62