


LATITUDE 38° 30'

LONGITUDE

81° 25'

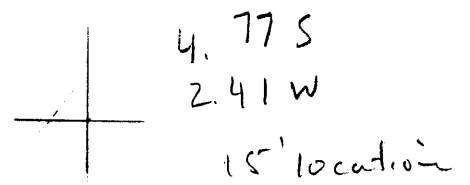

7'5 OGIS topo location

7.5' loc \_\_\_\_\_ 15' loc \_\_\_\_\_  
 \_\_\_\_\_ (calc.) \_\_\_\_\_

Company Ohio Fuel

Farm G. E. Myers 4

Quad Clendenin 15'

County Kanawha

District EIK

WELL LOCATION MAP

File No. 40198 70253

# 178 in Kanawha

1914WV6ES

County Report