


LATITUDE 38° 30'

LONGITUDE 81° 25'

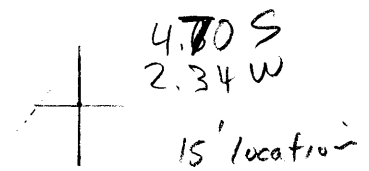

7'5 OGIS topo location

7.5' loc _____ 15' loc _____
 _____ (calc.) _____

Company Ohio Fuel

Farm G. E. Myers 2

Quad Clendenin 15'

County Kanawha

District EIK

WELL LOCATION MAP

File No. 40199 70254

#180 in Kanawha

1914 WVGES

County Report