


LATITUDE 38°30'

LONGITUDE 81°25'

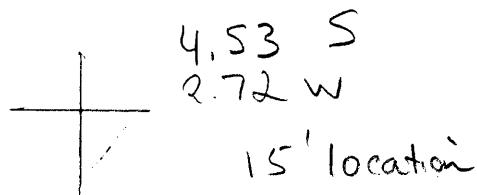

7.5 OGIS topo location

7.5' loc _____ 15' loc _____
 _____ (calc.) _____

Company Ohio Fuel

Farm G.W. White &

Quad Clendenin 15'

County Kanawha

District EIK

WELL LOCATION MAP

File No. 40203 70258

187 in Kanawha

1914WV6E County Report