


LATITUDE 38°30'

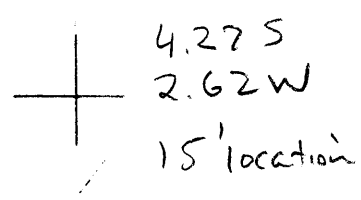

LONGITUDE 81°25'

7'5 OGIS topo location

7.5' loc \_\_\_\_\_ 15' loc \_\_\_\_\_  
 \_\_\_\_\_ (calc.) \_\_\_\_\_

Company Ohio Fuel

Farm Schwartz & Barth 4

Quad Cleundenin 15'

County Kanawha

District EIK

WELL LOCATION MAP

File No. 40211 70266

# 196 in Kanawha

1914 WVGES County Report