


LATITUDE 38° 30'

LONGITUDE 81° 25'

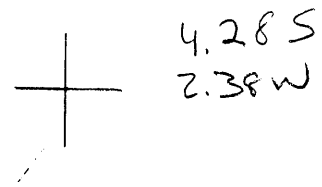

7'5 OGIS topo location

7.5' loc _____ 15' loc _____
 _____ (calc.) _____

Company Mazel Oil Co
 Farm School Lot 1
 Quad Clendenin 15'
 County Kanawha
 District EIK

WELL LOCATION MAP
 File No. 40213 70268
 #198 in Kanawha
 1914 WVGES county Report