


LATITUDE 38° 30'

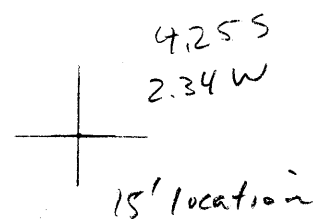

LONGITUDE 81° 25'

7'5 OGIS topo location

7.5' loc \_\_\_\_\_ 15' loc \_\_\_\_\_  
 \_\_\_\_\_ (calc.) \_\_\_\_\_

Company Hoze Oil Co

Farm School Lot 2

Quad Clendenin 15'

County Kanawha

District EIK

WELL LOCATION MAP

File No. 40215 70269

# 203 in Kanawha

1914 WUGES county Report