


LATITUDE 38° 30'

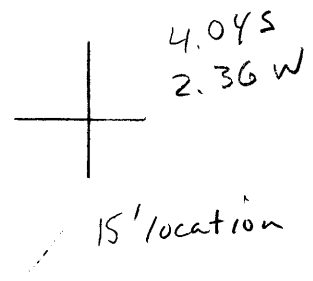

LONGITUDE 81° 25'

7'5 OGIS topo location

7.5' loc _____ 15' loc _____
 _____ (calc.) _____

Company Ohio Fuel
 Farm Schwartz & Barth 8
 Quad Clendenin 15'
 County Kanawha
 District EIK

WELL LOCATION MAP
 File No. 40217 70271
 #206 in Kanawha
 1914WV6ES County Report