


LATITUDE 38° 30'

LONGITUDE 81° 25'

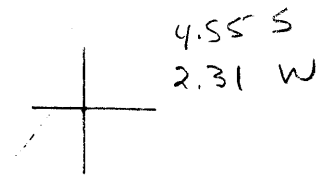

T'5 OGIS topo location

7.5' loc \_\_\_\_\_ 15' loc \_\_\_\_\_  
 \_\_\_\_\_ (calc.) \_\_\_\_\_

Company William S. Edwards Oil Co

Farm Graham Heirs 2

Quad Clendenin 15'

County Kanawha

District E/K

WELL LOCATION MAP  
 File No. 40220 70274  
 #212 in Kanawha  
 1914 WGES County Report