


LATITUDE 38° 30'

LONGITUDE 81° 25'

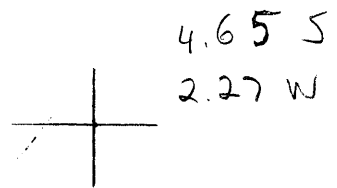

7'5 OGIS topo location

7.5' loc _____ 15' loc _____
 _____ (calc.) _____

Company Ohio Fuel Oil Co.

Farm G.E. Myers 1

Quad Clendenin 15'

County Kanawha

District E1K

WELL LOCATION MAP

File No. 40221 70275

~~20~~ 213 in

1914 WUGES Kanawha county
Report.