


LATITUDE 38°30'

LONGITUDE 81°25'

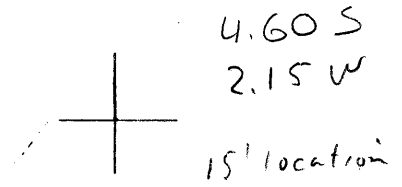

7.5 OGIS topo location

7.5' loc \_\_\_\_\_ 15' loc \_\_\_\_\_  
 \_\_\_\_\_ (calc.) \_\_\_\_\_

Company Ohio Fuel

Farm J. C. Jarrett I

Quad Clendenin 15'

County Kanawha

District E1K

WELL LOCATION MAP

File No. 40222 70276

# 214 in Kanawha

1914 WVGS County Report